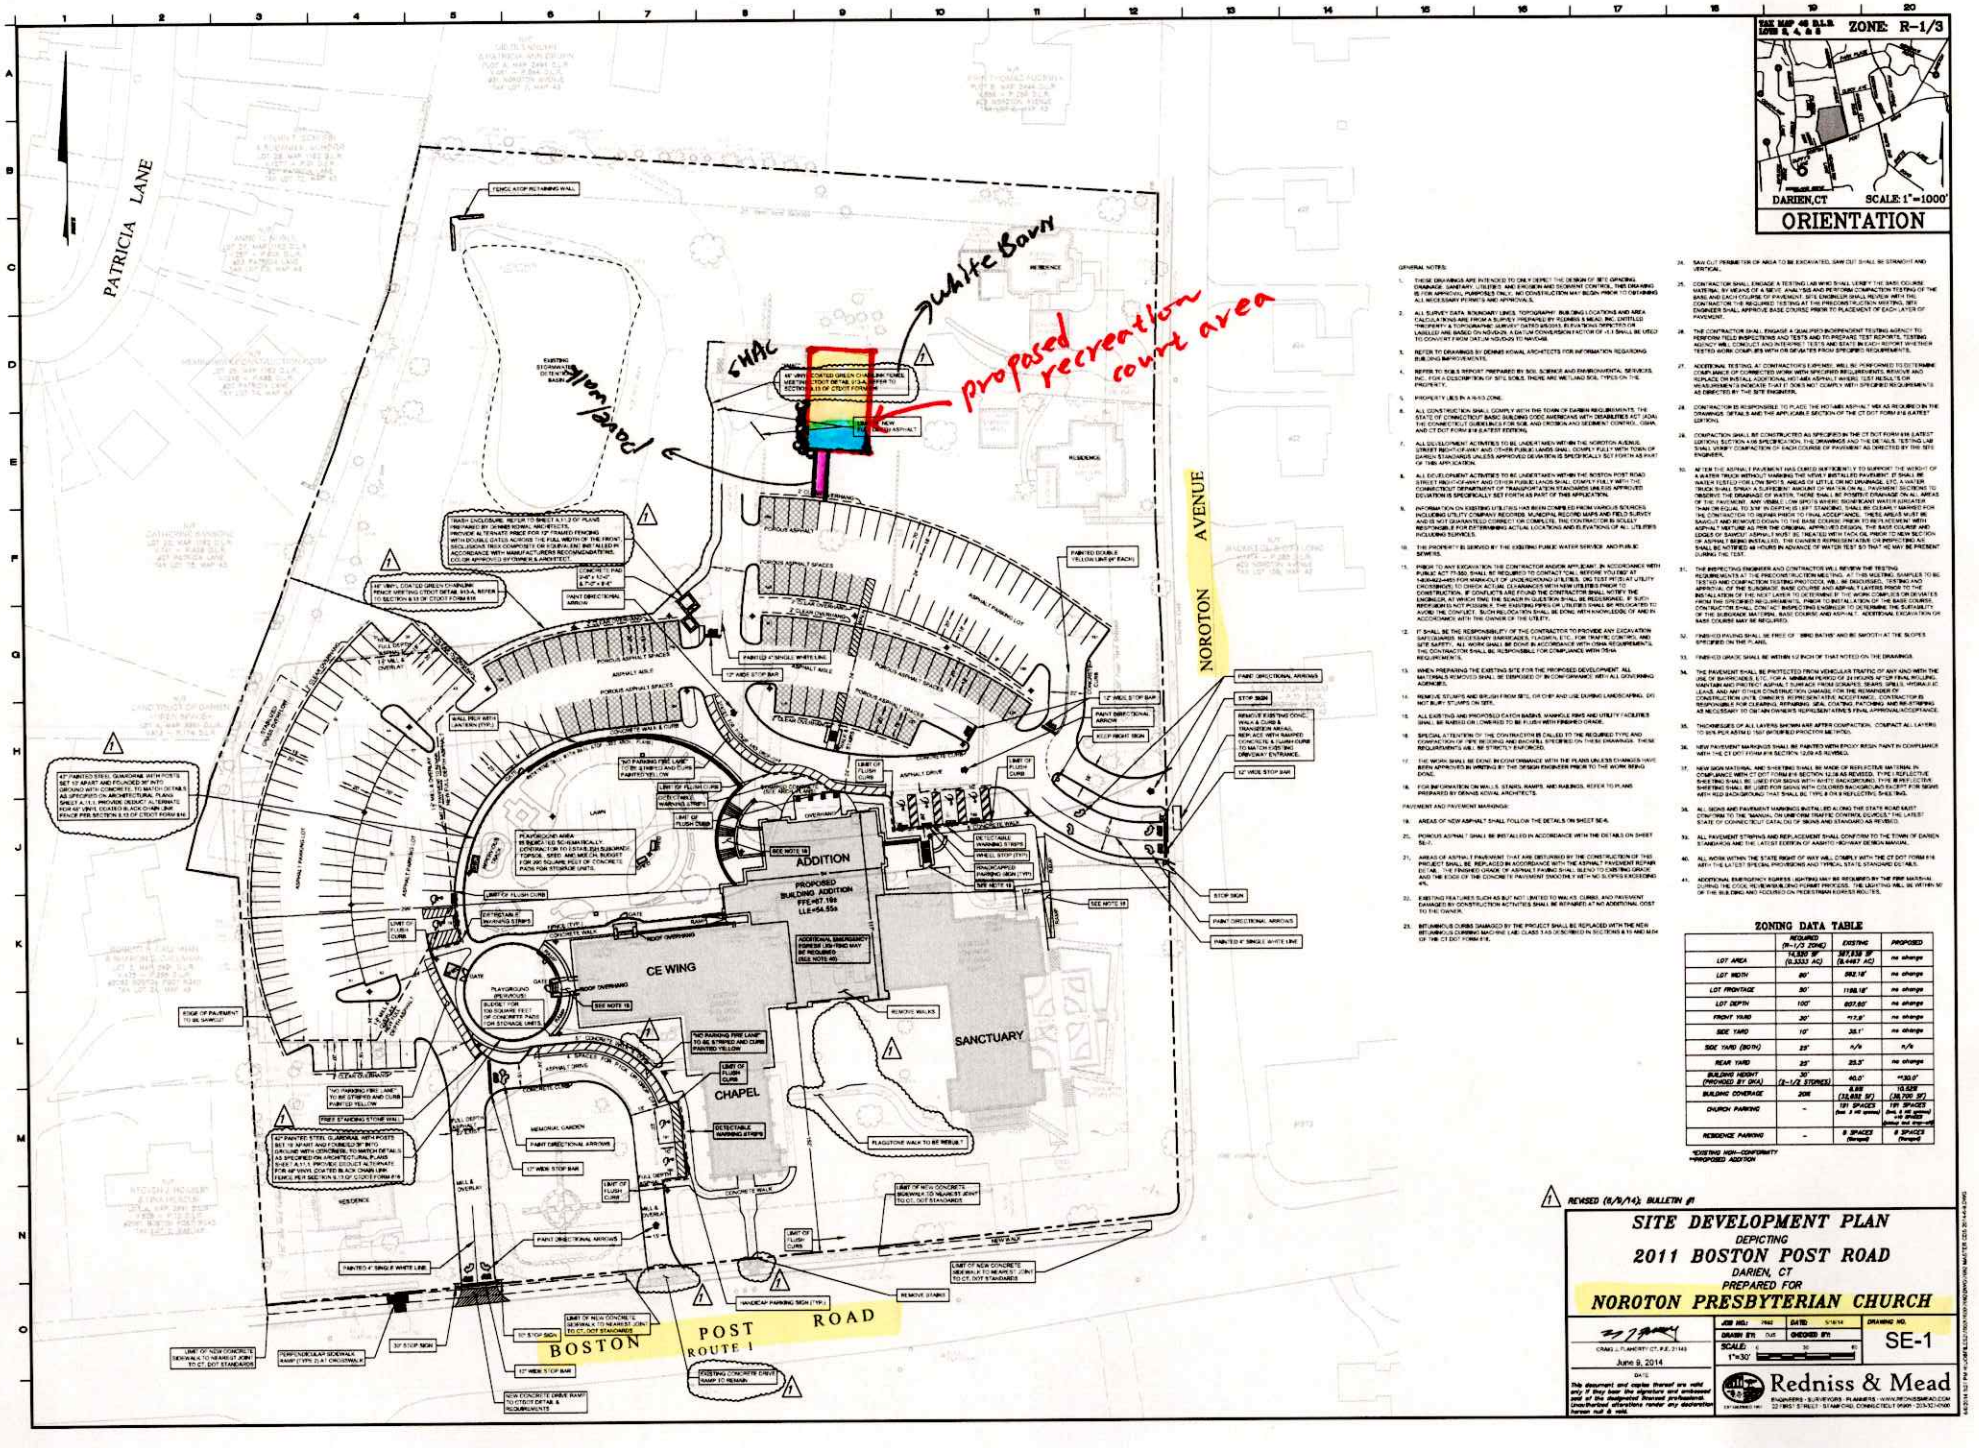

GENERAL NOTES:

1. THESE DRAWINGS ARE INTENDED TO ONLY DEPICT THE DESIGN OF SITE GRADING, DRAINAGE, SANITARY, UTILITIES, AND EROSION AND SEDIMENT CONTROL. THIS DRAWING IS FOR APPROVAL PURPOSES ONLY. NO CONSTRUCTION MAY BEGIN PRIOR TO OBTAINING ALL WOD ESWRV PERMITS AND APPROVALS.
2. ALL SURVEY DATA, BOUNDARY LINES, TOPOGRAPHY, BUILDING LOCATIONS AND AREA CALCULATIONS ARE FROM A SURVEY PREPARED BY FLORIES & MEAD, INC. ENTITLED "PROPERTY & TOPOGRAPHIC SURVEY DATED 4/8/2013, ELEVATIONS SHOWN OR LABELED ARE BASED ON NGVD29. A DATUM CONVERSION FACTOR OF -0.5 SHALL BE USED TO CONVERT FROM DATUM NGVD29 TO NAVD88.
3. REFER TO DRAWINGS BY DENNIS KOWAL ARCHITECTS FOR INFORMATION REGARDING BUILDING IMPROVEMENTS.
4. REFER TO SOILS REPORT PREPARED BY SOIL SCIENCE AND ENVIRONMENTAL SERVICES, INC., FOR A DESCRIPTION OF SITE SOILS. THERE ARE WETLAND SOIL TYPES ON THE PROPERTY.
5. PROPERTY LIES IN A R-1/3 ZONE.
6. ALL CONSTRUCTION SHALL COMPLY WITH THE TOWN OF DARIEN REQUIREMENTS, THE STATE OF CONNECTICUT BASIC BUILDING CODE AMENDING WITH DISABILITIES ACT (ADA), THE CONNECTICUT GUIDELINES FOR SOIL AND EROSION AND SEDIMENT CONTROL, OSHA, AND CT DOT FORM 816 LATEST EDITION.
7. ALL DEVELOPMENT ACTIVITIES TO BE UNDERTAKEN WITHIN THE NOROTON AVENUE, STREET RIGHT-OF-WAY, AND OTHER PUBLIC LANDS SHALL COMPLY FULLY WITH TOWN OF DARIEN STANDARDS UNLESS APPROVED DEVIATIONS IS SPECIFICALLY SET FORTH AS PART OF THIS APPLICATION.
8. ALL DEVELOPMENT ACTIVITIES TO BE UNDERTAKEN WITHIN THE BOSTON POST ROAD STREET RIGHT-OF-WAY AND OTHER PUBLIC LANDS SHALL COMPLY FULLY WITH THE STREET TREE PROTECTION AND PLANTING STANDARDS UNLESS APPROVED DEVIATION IS SPECIFICALLY SET FORTH AS PART OF THIS APPLICATION.
9. INFORMATION ON EXISTING UTILITIES HAS BEEN COMPILED FROM VARIOUS SOURCES, INCLUDING UTILITY COMPANY RECORDS, MUNICIPAL RECORD MAPS AND FIELD SURVEY AND IS NOT GUARANTEED CORRECT OR COMPLETE. THE CONTRACTOR IS SOLELY RESPONSIBLE FOR DETERMINING ACTUAL LOCATIONS AND ELEVATIONS OF ALL UTILITIES INCLUDING SERVICES.
10. THE PROPERTY IS SERVED BY THE EXISTING PUBLIC WATER SERVICE AND PUBLIC SEWERS.
11. PRIOR TO ANY EXCAVATION, THE CONTRACTOR AND/OR APPLICANT, IN ACCORDANCE WITH PUBLIC ACT 77-502, SHALL BE REQUIRED TO CONTACT CBYU, BEFORE YOU DIG AT 1-800-922-4455 FOR MARK-OUT OF UNDERGROUND UTILITIES. (NO TEST PIT OR UTILITY CROSSINGS TO DRIVE ACTUAL CLEARANCES WITH NEW UTILITIES PRIOR TO CONSTRUCTION. IF CONFLICTS ARE FOUND THE CONTRACTOR SHALL NOTIFY THE ENGINEER, AT WHICH TIME THE DESIGN IN QUESTION WILL BE RESCHEDULED. IF SUCH RECISION IS NOT POSSIBLE, THE EXISTING PIPES OR UTILITIES SHALL BE RELOCATED TO AVOID THE CONFLICT. SUCH RELOCATION SHALL BE DONE WITH KNOWLEDGE OF AND IN ACCORDANCE WITH THE OWNER OF THE UTILITY.
12. IT SHALL BE THE RESPONSIBILITY OF THE CONTRACTOR TO PROVIDE ANY EXCAVATION SAFEGUARDS NECESSARY (BARRICADES, FLAGGERS, ETC.) FOR TRAFFIC CONTROL AND SITE SAFETY. ALL WORK SHALL BE DONE IN ACCORDANCE WITH OSHA REQUIREMENTS. THE CONTRACTOR SHALL BE RESPONSIBLE FOR COMPLIANCE WITH THESE REQUIREMENTS.
13. WHEN PREPARING THE EXISTING SITE FOR THE PROPOSED DEVELOPMENT, ALL MATERIALS REMOVED SHALL BE DISPOSED OF IN CONFORMANCE WITH ALL GOVERNING AGENCIES.
14. REMOVE STUMPS AND BRUSH FROM SITE, OR CHIP AND USE DURING LANDSCAPING. DO NOT BURY STUMPS ON SITE.
15. ALL EXISTING AND PROPOSED CATCH BASINS, MANHOLE RIMS AND UTILITY FACILITIES SHALL BE ADJUSTED OR CONSTRUCTED TO BE FLUSH WITH FINISHED GRADE.
16. SPECIAL ATTENTION OF THE CONTRACTOR IS CALLED TO THE REQUIRED TYPE AND CONSTRUCTION OF TIPE BUILDING AND BASEMENT SPECIFIED ON THESE DRAWINGS. THESE REQUIREMENTS ARE TO BE STRICTLY ADHERED TO.
17. THE WORK SHALL BE DONE IN CONFORMANCE WITH THE PLANS UNLESS CHANGES HAVE BEEN APPROVED IN WRITING BY THE DESIGN ENGINEER PRIOR TO THE WORK BEING DONE.
18. FOR INFORMATION ON WALLS, STAIRS, RAMPS, AND RAILINGS, REFER TO PLANS PREPARED BY DENNIS KOWAL ARCHITECTS.

PAVEMENT AND PAVEMENT MARKINGS:

19. AREAS OF NEW ASPHALT SHALL FOLLOW THE DETAILS ON SHEET SE-4.
20. POROUS ASPHALT SHALL BE INSTALLED IN ACCORDANCE WITH THE DETAILS ON SHEET SE-7.
21. AREAS OF ASPHALT PAVEMENT THAT ARE DISTURBED BY THE CONSTRUCTION OF THIS PROJECT SHALL BE REPLACED IN ACCORDANCE WITH THE ASPHALT PAVEMENT REPAIR DETAIL. THE FINISHED GRADE OF ASPHALT PAVING SHALL SLEND TO CATCH BASIN GRADE AND THE EDGE OF THE CONCRETE PAVEMENT SMOOTH T VETH NO SLOPES EXCEEDING 4%.
22. EXISTING FEATURES SUCH AS BUT NOT LIMITED TO WALKS, CURBS, AND PAVEMENT DAMAGED BY CONSTRUCTION ACTIVITIES SHALL BE REPAIRED AT NO ADDITIONAL COST TO THE OWNER.
23. BITUMINOUS CURBS DAMAGED BY THE PROJECT SHALL BE REPLACED WITH THE NEW BITUMINOUS CURBING MACHINE LINE CLASS 1 AS DESCRIBED IN SECTION 9.15 AND M4.04 OF THE CT DOT FORM 816.
24. SAW CUT PERIMETER OF AREA TO BE EXCAVATED, SAW CUT SHALL BE STRAIGHT AND VERTICAL.
25. CONTRACTOR SHALL ENGAGE A TESTING LAB WHO SHALL VERIFY THE BASE COURSE MATERIAL BY MEANS OF A SIEVE ANALYSIS AND PERFORM COMPACTION TESTING OF THE BASE AND EACH COURSE OF PAVEMENT. SITE ENGINEER SHALL REVIEW WITH THE CONTRACTOR THE REQUIRED TESTING AT THE PRECONSTRUCTION MEETING. SITE ENGINEER SHALL APPROVE BASE COURSE PRIOR TO PLACEMENT OF EACH LAYER OF PAVEMENT.
26. THE CONTRACTOR SHALL ENGAGE A QUALIFIED INDEPENDENT TESTING AGENCY TO PERFORM FIELD INSPECTIONS AND TESTS AND TO PREPARE TEST REPORTS. TESTING AGENCY WILL CONDUCT AND INTERPRET TESTS AND STATE IN EACH REPORT WHETHER TESTED WORK COMPLIES WITH OR DEVIATES FROM SPECIFIED REQUIREMENTS.
27. ADDITIONAL TESTING, AT CONTRACTOR'S EXPENSE, WILL BE PERFORMED TO DETERMINE COMPLIANCE OF CORRECTED WORK WITH SPECIFIED REQUIREMENTS. REMOVE AND REPLACE OR INSTALL ADDITIONAL NOT MIX ASPHALT WHERE TEST RESULTS OR VISUAL EVIDENCE INDICATE THAT IT DOES NOT COMPLY WITH SPECIFIED REQUIREMENTS AS DIRECTED BY THE SITE ENGINEER.
28. CONTRACTOR IS RESPONSIBLE TO PLACE THE HOT-MIX ASPHALT MIX AS REQUIRED IN THE DRAWINGS, DETAIL 5 AND THE APPLICABLE SECTION OF THE CT DOT FORM 816 LATEST EDITION.
29. COMPACTION SHALL BE CONSTRUCTED AS SPECIFIED IN THE CT DOT FORM 816 LATEST EDITION, SECTION 4.06 SPECIFICATION. THE DRAWINGS AND THE QA/QC TESTING LAB SHALL VERIFY COMPACTION OF EACH COURSE OF PAVEMENT AS DIRECTED BY THE SITE ENGINEER.
30. AFTER THE ASPHALT PAVEMENT HAS CURED SUFFICIENTLY TO SUPPORT THE WEIGHT OF A WATER TRUCK WITHOUT MARKING THE VIRGIN INSTALLED PAVEMENT, IF SHALL BE WATER TESTED FOR LOW SPOTS, AREAS OF LITTLE OR NO DRAINAGE, ETC. A WATER TRUCK SHALL SPRAY A SUFFICIENT AMOUNT OF WATER ON ALL PAVEMENT SECTIONS TO OBSERVE THE DRAINAGE OF WATER. THERE SHALL BE PONDED DRAINAGE ON ALL AREAS OF THE PAVEMENT. ANY AREAS (OR SPOTS WHERE) SIGNIFICANT WATER (GREATER THAN OR EQUAL TO 3/16" IN DEPTH) IS LEFT STANDING, SHALL BE CLEARLY MARKED FOR THE CONTRACTOR TO REPAIR PRIOR TO FINAL ACCEPTANCE. THESE AREAS MUST BE SAWCUT AND REMOVED DOWN TO THE BASE COURSE PRIOR TO REPLACEMENT WITH ASPHALT MATTER AS PER THE ORIGINAL APPROVED DESIGN. THE BASE COURSE AND EDGES OF SAWCUT ASPHALT MUST BE TREATED WITH TACK OIL PRIOR TO NEW SECTION OF ASPHALT BEING INSTALLED. THE CONTRACTOR REPRESENTATIVE DIRECTING AS SHALL BE NOTIFIED 48 HOURS IN ADVANCE OF WATER TEST SO THAT HE MAY BE PRESENT DURING THE TEST.
31. THE INSPECTING ENGINEER AND CONTRACTOR WILL REVIEW THE TESTING REQUIREMENTS AT THE PRECONSTRUCTION MEETING. AT THIS MEETING SAMPLES TO BE TESTED AND COMPACTION TESTING PROTOCOL WILL BE DISCUSSED. TESTING AND APPROVAL OF THE SUBGRADE, BASE COURSE AND ASPHALT LAYERS PRIOR TO THEIR INSTALLATION OF THE NEXT LAYER IS REQUIRED. THE CONTRACTOR SHALL NOTIFY THE INSPECTING ENGINEER AT LEAST 48 HOURS IN ADVANCE OF PLACING THE BASE COURSE. INSPECTING ENGINEER TO DETERMINE THE SUITABILITY OF THE SUBGRADE MATERIAL, BASE COURSE AND ASPHALT. ADDITIONAL EXCAVATION FOR BASE COURSE MAY BE REQUIRED.
32. FINISHED PAVING SHALL BE FREE OF BIRD BATHS AND BE SMOOTH AT THE SLOPES SPECIFIED ON THE PLANS.
33. FINISHED GRADE SHALL BE WITHIN 1/2 INCH OF THAT NOTED ON THE DRAWINGS.
34. THE PAVEMENT SHALL BE PROTECTED FROM VEHICULAR TRAFFIC OF ANY KIND WITH THE USE OF BARRICADES, ETC. FOR A MINIMUM PERIOD OF 24 HOURS AT NOT FINAL ROLLING, VANTAGE AND PROTECT ASPHALT SURFACE FROM CRANES, GEARS, SPILLS, HYDRAULIC LEAKS, AND ANY OTHER CONSTRUCTION DAMAGE FOR THE REMAINDER OF CONSTRUCTION. OWNER'S REPRESENTATIVE ACCEPTANCE. CONTRACTOR IS RESPONSIBLE FOR CLEANING, REPAIRING, SEAL COATING, PATCHING AND RE-STRIPING AS NECESSARY OF ON-SITE PAVEMENTS SUPERSEDING ATHEY'S FINAL APPROVAL/ACCEPTANCE.
35. THICKNESSES OF ALL LAYERS SHOWN ARE AFTER COMPACTION. COMPACT ALL LAYERS TO 95% PER ASTM D 1557 (MODIFIED PROCTOR METHOD).
36. NEW PAVEMENT MARKINGS SHALL BE PAINTED WITH EPOXY RESIN PAINT IN COMPLIANCE WITH THE CT DOT FORM 816 SECTION 12.09.43 AS REVISED.
37. NEW SIGN MATERIAL AND SHEETING SHALL BE MADE OF REFLECTIVE MATERIAL IN COMPLIANCE WITH CT DOT FORM 816 SECTION 12.08 AS REVISED. TYPE I REFLECTIVE SHEETING SHALL BE USED FOR SIGNS WITH WHITE BACKGROUND. TYPE III REFLECTIVE SHEETING SHALL BE USED FOR SIGNS WITH COLORED BACKGROUND EXCEPT FOR SIGNS WITH RED BACKGROUND WHICH SHALL BE TYPE II OR III REFLECTIVE SHEETING.
38. ALL SIGNS AND PAVEMENT MARKINGS INSTALLED ALONG THE STATE ROAD MUST CONFORM TO THE MANUAL ON UNIFORM TRAFFIC CONTROL DEVICES (MUTCD) THE LATEST STATE OF CONNECTICUT DATA, DOT SIGNS AND STANDARDS AS REVISED.
39. ALL PAVEMENT STRIPING AND REPLACEMENT SHALL CONFORM TO THE TOWN OF DARIEN STANDARDS AND THE LATEST EDITION OF AASHTO HIGHWAY DESIGN MANUAL.
40. ALL WORK WITHIN THE STATE RIGHT OF WAY WILL COMPLY WITH THE CT DOT FORM 816 WITH THE LATEST SPECIAL PROVISIONS AND THOSE STATE STANDARD DETAILS.
41. ADDITIONAL EMERGENCY EGRESS LIGHTING MAY BE REQUIRED BY THE FIRE MARSHAL DURING THE CODE REVIEW/BUILDING PERMIT PROCESS. THE LIGHTING WILL BE WITHIN 90' OF THE BUILDING AND FOCUSED ON PEDESTRIAN EGRESS ROUTES.

ZONING DATA TABLE

	REQUIRED R-1/3 ZONE	EXISTING	PROPOSED
LOT AREA	14,000 SF (0.3333 AC)	397,836 SF (9.467 AC)	no change
LOT WIDTH	80'	592.18'	no change
LOT FRONTAGE	50'	1186.18'	no change
LOT DEPTH	100'	607.65'	no change
FRONT YARD	30'	*17.5'	no change
SIDE YARD	10'	38.1'	no change
SIDE YARD (BOTH)	25'	n/a	n/a
REAR YARD	25'	25.3'	no change
BUILDING HEIGHT (PROVIDED BY DKA)	2-1/2 STORIES	40.0'	*43.0'
BUILDING COVERAGE	20%	6.8% (26,966 SF)	10.62% (38,700 SF)
CHURCH PARKING	-	131 SPACES (incl. 7 handicap)	181 SPACES (incl. 8 handicap and 2 compact)
RESIDENCE PARKING	-	2 SPACES (Garage)	2 SPACES (Garage)

*EXISTING NON-CONFORMITY
*PROPOSED ADDITION

REVISED (6/9/14); BULLETIN #1

SITE DEVELOPMENT PLAN

DEPICTING

2011 BOSTON POST ROAD

DARIEN, CT

PREPARED FOR

NOROTON PRESBYTERIAN CHURCH

CRAIG L. FLAHERTY, CT, P.E. 21143

June 9, 2014

DATE

This document and reports thereof are valid only if they bear the signature and embossed seal of the designated licensed professional. Unauthorized alterations render any declaration thereon null & void.

JOB NO.: 7440 | DATED: 5/16/14 | DRAWING NO.: SE-1

DRAWN BY: DJS | CHECKED BY:

SCALE: 1"=30'

Redniss & Mead

ENGINEERS · SURVEYORS · PLANNERS · WWW.REDNISSMEAD.COM

